



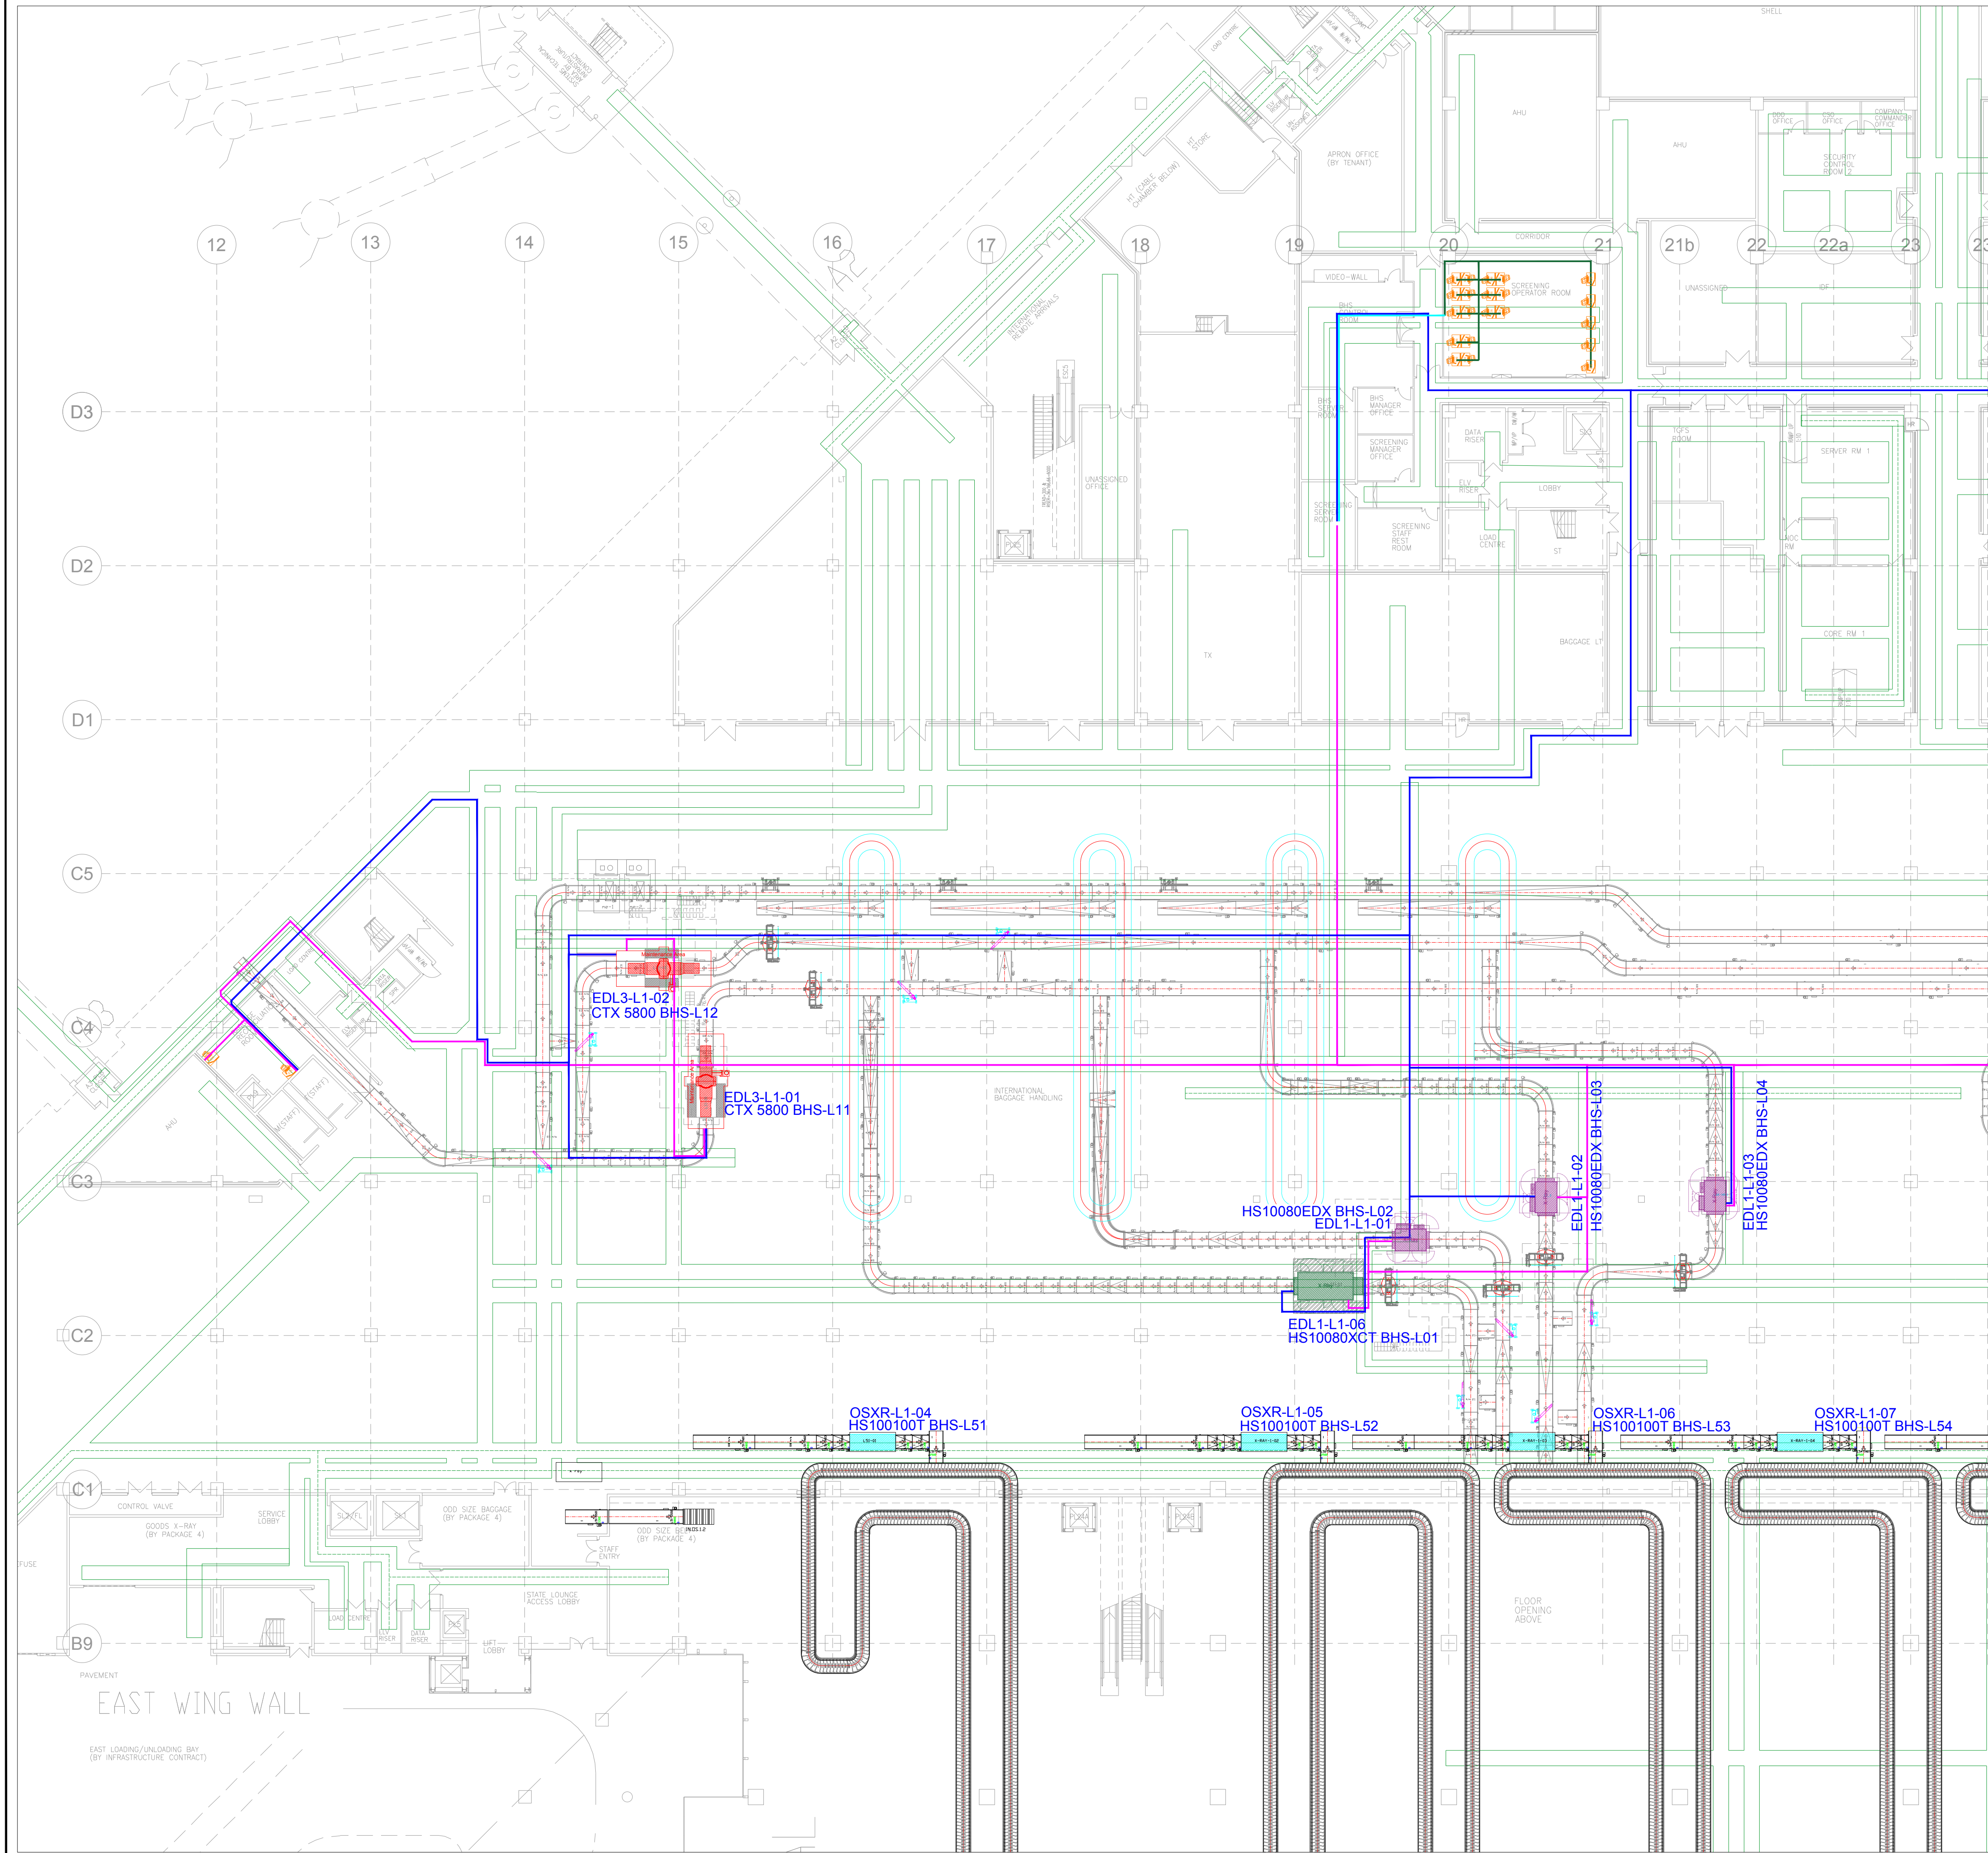

Legend		Legend	
	Explosion Detector X-Ray STD 3 Machine Model CTX 5800		Cable Tray
	Explosion Detector X-Ray STD 3 Machine Model HS10080EDX		GI Conduit
	Explosion Detector X-Ray STD 3 Machine Model HS10080EDX		FC Single Mode Fiber
	Explosion Detector X-Ray STD 3 Machine Model HS10080EDX		FC Single Mode Fiber Redundant Pair
	Explosion Detector X-Ray STD 3 Machine Model HS10080EDX		FTP Cat5 Cable
	Explosion Detector X-Ray STD 3 Machine Model HS10080EDX		FTP Cat6 Cable
	Explosion Detector X-Ray STD 3 Machine Model HS10080EDX		Under Raised Floor

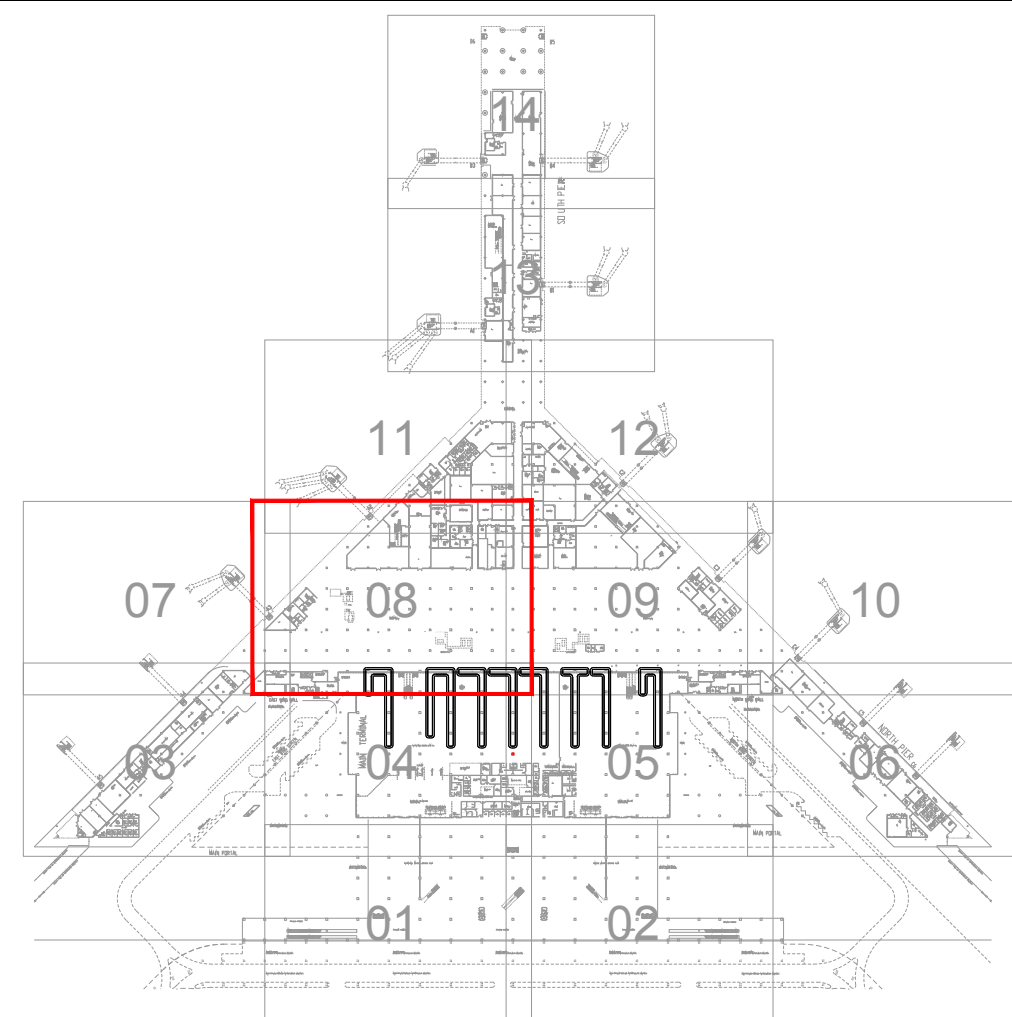

CLIENT

PROJECT MANAGEMENT CONSULTANT

M/s Mott MacDonald-Pakistan (Pvt) Ltd.
Pind Rana Fateh - (c/o OCS Fateh Jang)
Islamabad, Pakistan

PRINCIPAL DESIGN CONSULTANT

No.1 KAKI BUKIT #01-01/07 TECHVIEW
SINGAPORE 415941
TEL: 65 65475080 FAX: 65 65420406

ASSOCIATE DESIGN CONSULTANT

Arcorp (Pvt) Ltd

6C, Sunset Commercial Street No. 4 Phase IV
D.H.A. Karachi, Pakistan

Mushtaq & Bilal Consulting Engineers

304, Noor Estate, Sharaf Faisal
Karachi-75350, Pakistan

S. Mehboob & Company Consulting Engineers

Suite #5, 4th Floor, Dean Arcade Clifton, Block 8
Karachi-75600, Pakistan

CONTRACTOR

This drawing has been checked for compliance with the design intent comments below

- ☐ Approved
- ☐ Approved with comments
- ☐ Approved with comments & resubmit
- ☐ Not approved

The approval of this submittals does not relieve the contractor of the responsibilities for errors, full compliance with technical specification, contract drawings and other contract documents, completeness and good engineering practice.

The contractor is responsible for all the dimensions which shall be confirmed and correlated at site, fabrication process, techniques of construction and coordination with all other trades.

Approved,
For Employer

Date:

AS BUILT

JOB TITLE:
ISLAMABAD INTERNATIONAL AIRPORT PROJECT
PACKAGE 4 - PASSENGER TERMINAL BUILDING
AIRPORT SPECIAL SYSTEM

DRAWING TITLE
Inline Security Check Equipment - Positioning Layout - LEVEL 1 - Sheet 08

As Built		DOCUMENT NUMBER 99501813400002597046	Level 01 - Annex 08	Format A1 Scale 1:250
5				
4				
3				
2	27/03/2020	As Built	Sizzi M.	Pacini S.
1	27/02/2020	As Built	Sizzi M.	Pacini S.
Rev.	Date	Description	Drawing By	Checked By