



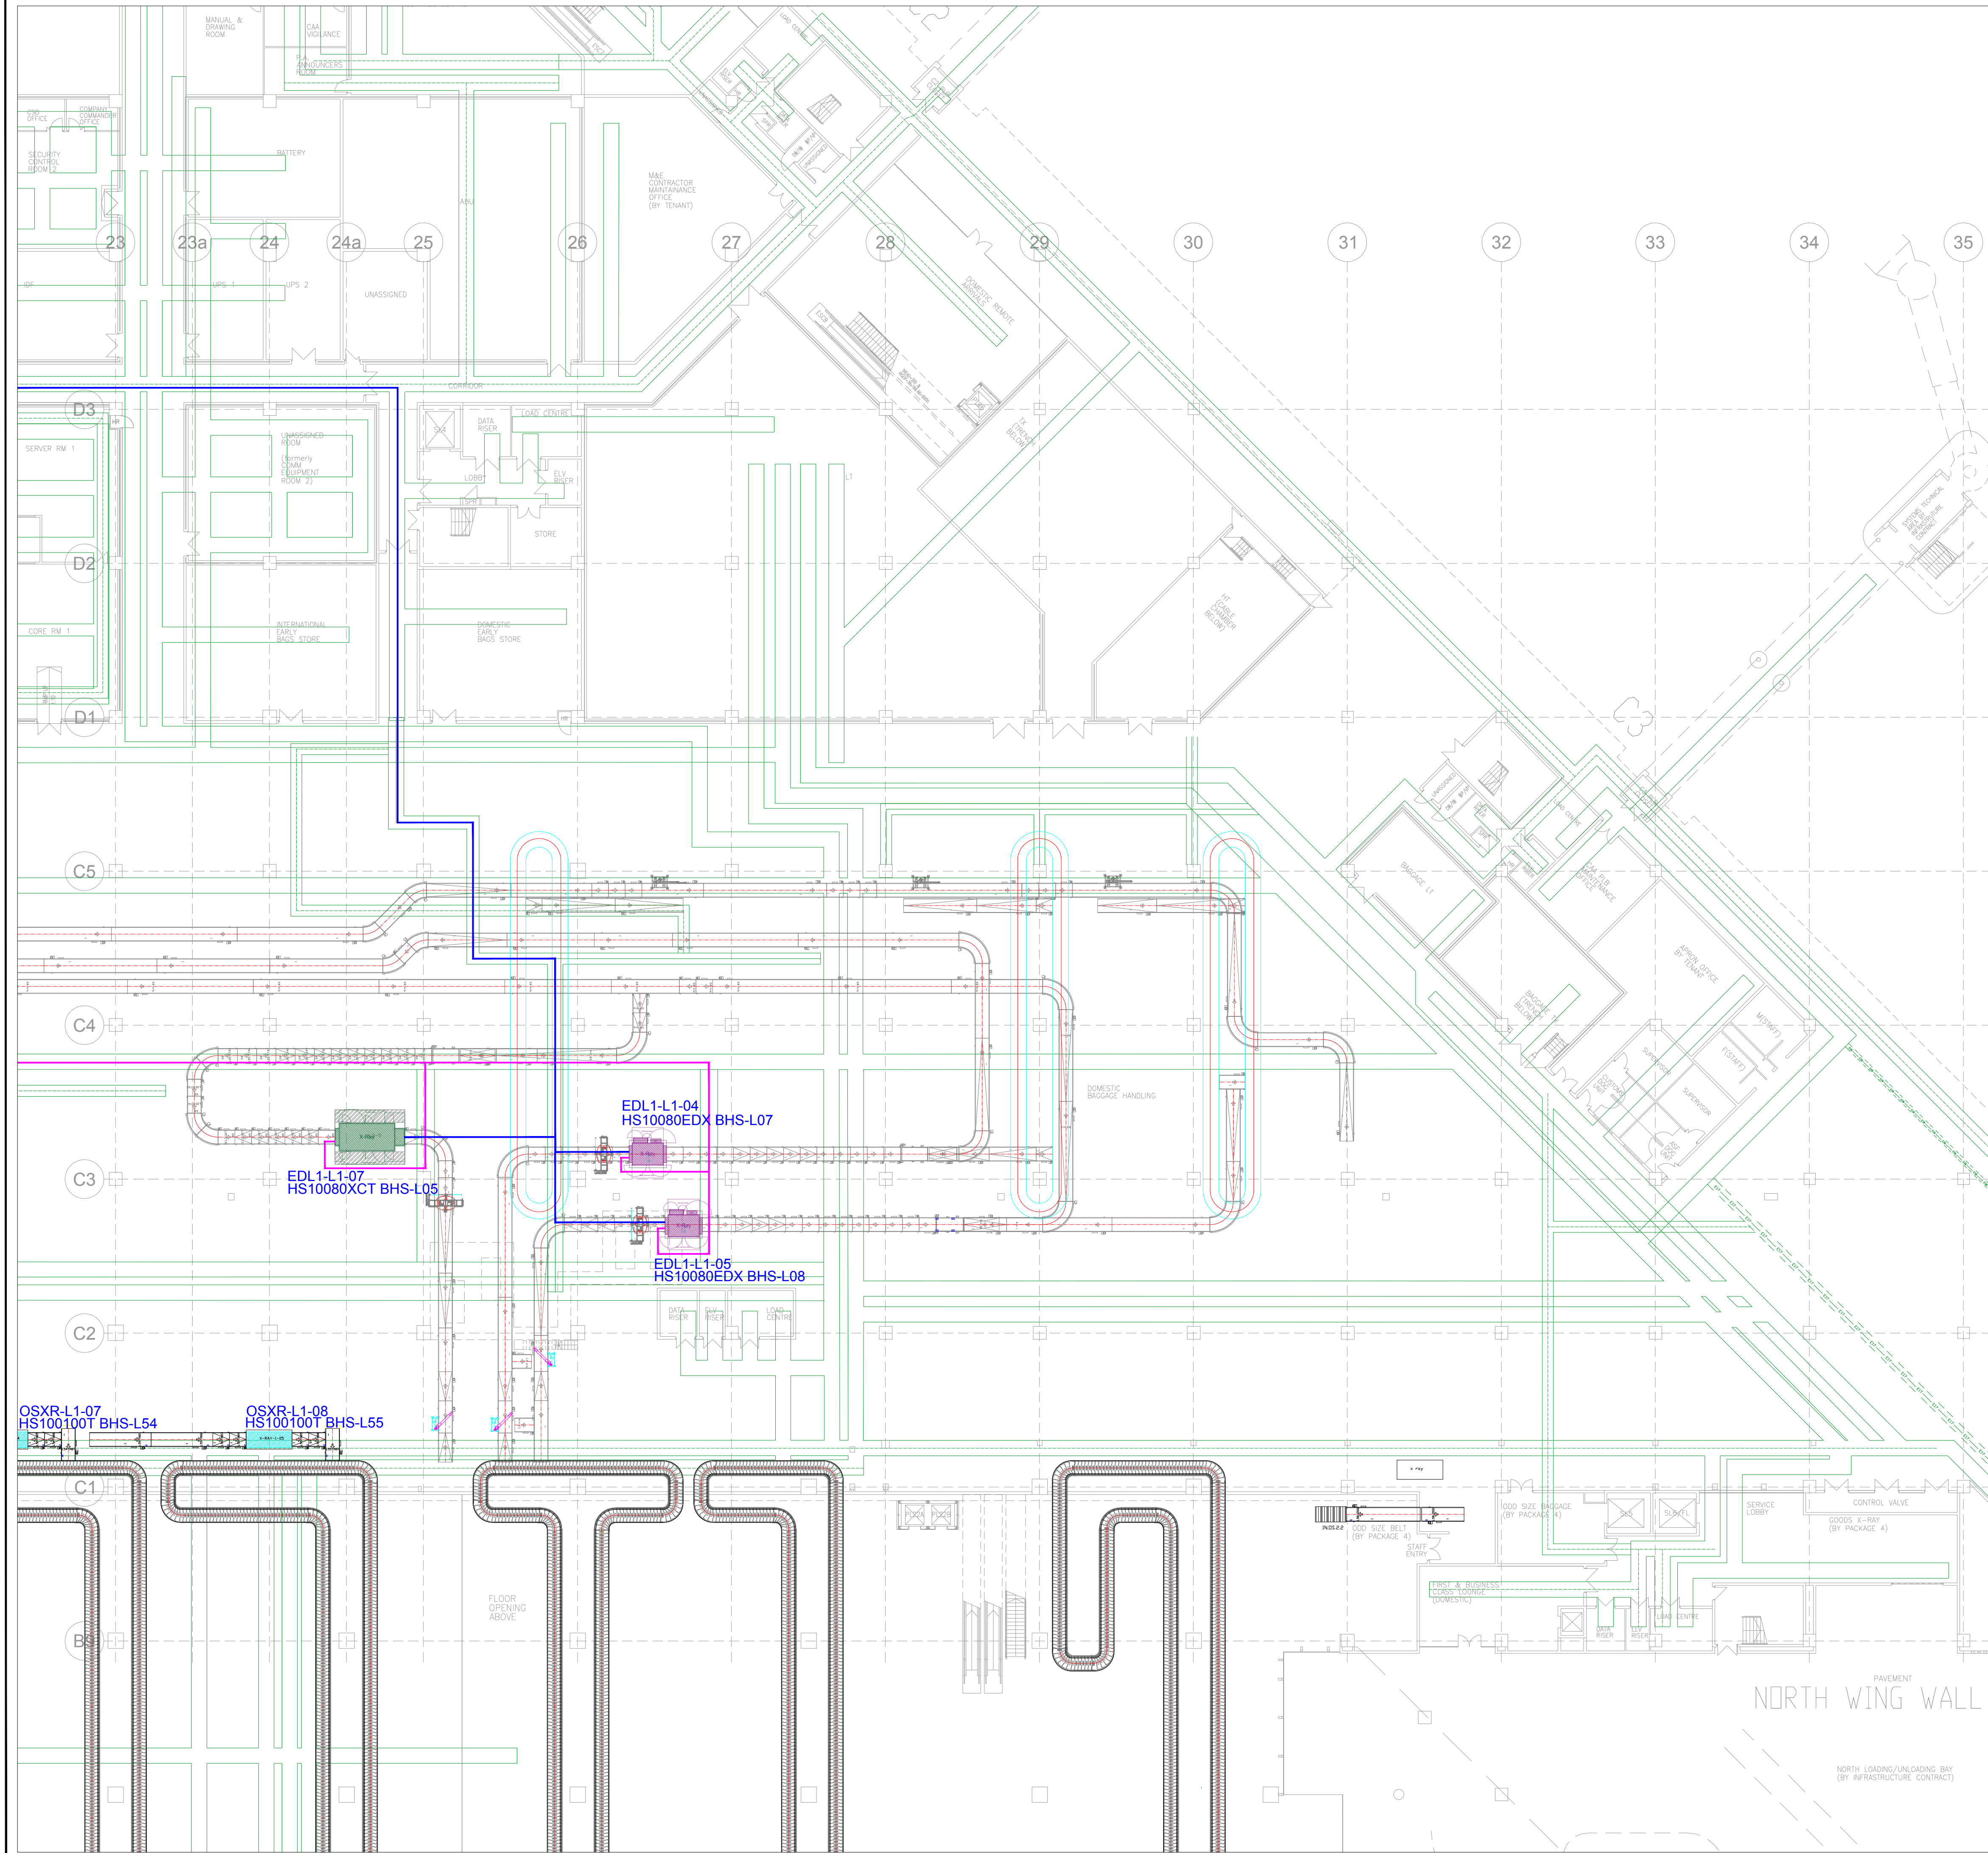

Legend	
	Explosive Detector X-Ray STD 3 Machine Model CTX 8600
	Explosive Detector X-Ray STD 2 Machine Model HS10080EDX
	Explosive Detector X-Ray STD 3 Machine Model HS10080XCT
	ODI size Baggage X-Ray Machine Model HS100100T
	SCC Registration

Legend	
	Cable Tray
	OD Conduit
	FD Single Mode Fiber
	FD Single Mode Fiber
	FTP Cat7 Cable
	FTP Cat7 Cable
	Under Raised Floor

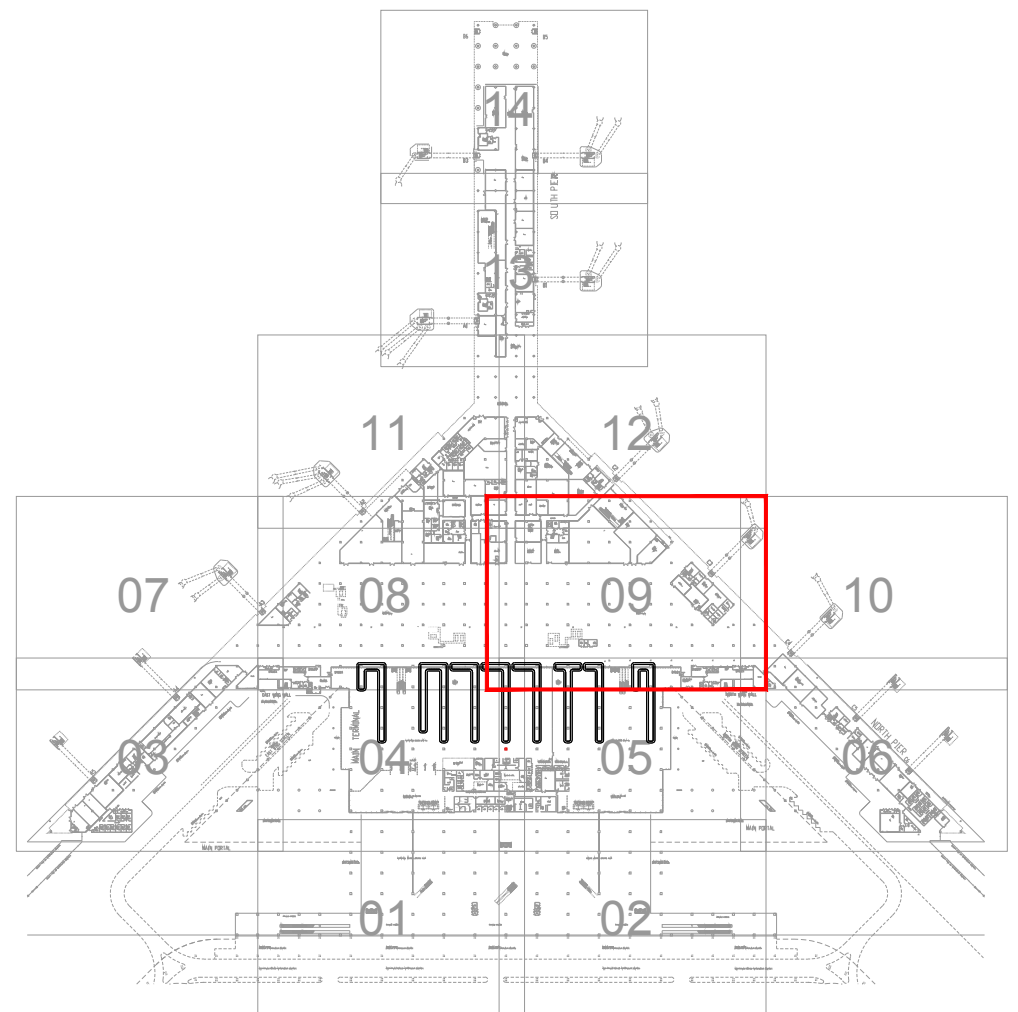

Key Plan



CLIENT

PROJECT MANAGEMENT CONSULTANT

PRINCIPAL DESIGN CONSULTANT

ASSOCIATE DESIGN CONSULTANT

Arcorp (Pvt) Ltd

6C, Sunset Commercial Street No. 4 Phase IV D.H.A. Karachi, Pakistan

Mushtaq & Bilal Consulting Engineers

304, Noor Estate, Sharaf Faisal Karachi-75350, Pakistan

S. Mehboob & Company Consulting Engineers

Suite #5, 4th Floor, Dean Arcade Clifton, Block 8 Karachi-75600, Pakistan

CONTRACTOR

This drawing has been checked for compliance with the design intent comments below

- ☐ Approved
- ☐ Approved with comments
- ☐ Approved with comments & resubmit
- ☐ Not approved

The approval of this submittals does not relieve the contractor of the responsibilities for errors, full compliance with technical specification, contract drawings and other contract documents, completeness and good engineering practice.

The contractor is responsible for all the dimensions which shall be confirmed and correlated at site, fabrication process, techniques of construction and coordination with all other trades.

Approved, For Employer

Date:

AS BUILT

JOB TITLE:
**ISLAMABAD INTERNATIONAL AIRPORT PROJECT
PACKAGE 4 - PASSENGER TERMINAL BUILDING
AIRPORT SPECIAL SYSTEM**

DRAWING TITLE Inline Security Check Equipment - Positioning Layout - LEVEL 1 - Sheet 09					
As Built		DOCUMENT NUMBER 99501813400002597046	Level 01 - Annex 09	Format A1 Scale 1:250	
5					
4					
3					
2	27/03/2020	As Built	Sizzi M.	Pacini S.	Pepponi D.
1	27/02/2020	As Built	Sizzi M.	Pacini S.	Pepponi D.
Rev.	Date	Description	Drawing By	Checked By	Approved By